


IP Camera System

AS Built 8/19/2014

Sheet 1 of 3

By: James Brennan

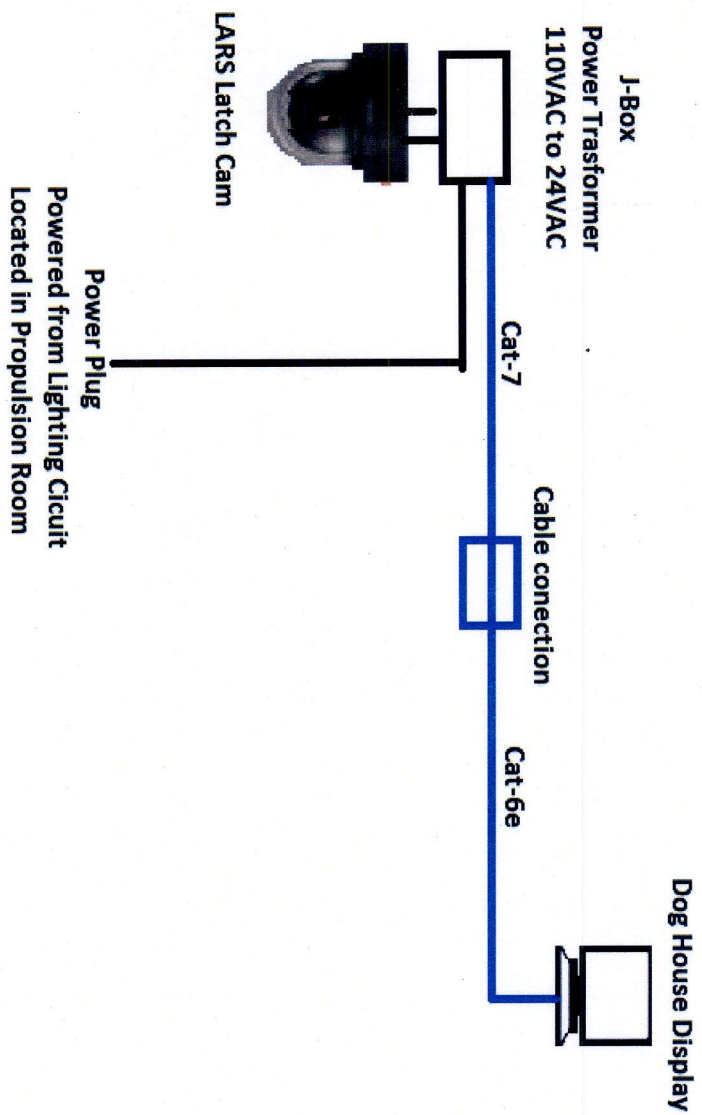

Fi

IP Camera System

AS Built 8/19/2014

Sheet 2 of 3 By: James Brennan



NVR, Network Video Recorder




Touch Screen Computer Terminals, Provided



Gigabit 4 Port POE 8 Port Switch



Gigabit 16 Port Switch

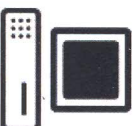

Desktop PC Workstations, Existing
With Special Ethernet Ports for Dual Use



Gigabit 8 Port Switch



Cisco WiFi Routers
Provided WAN for IP Cam network access



Gigabit 5 Port Switch



Cat 6, Cable Color Orange



Panasonic IP Cameras



Cat 5E, Cable Color Blue

IP Camera System

AS Built 8/19/2014